




SUB-MAIN-G

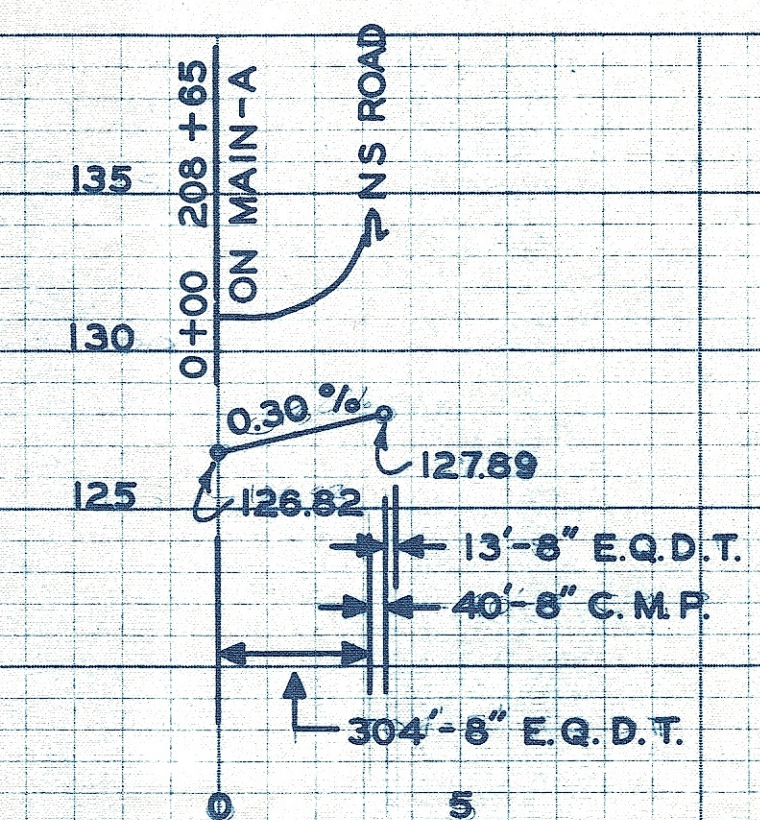


SUB-MAIN-F

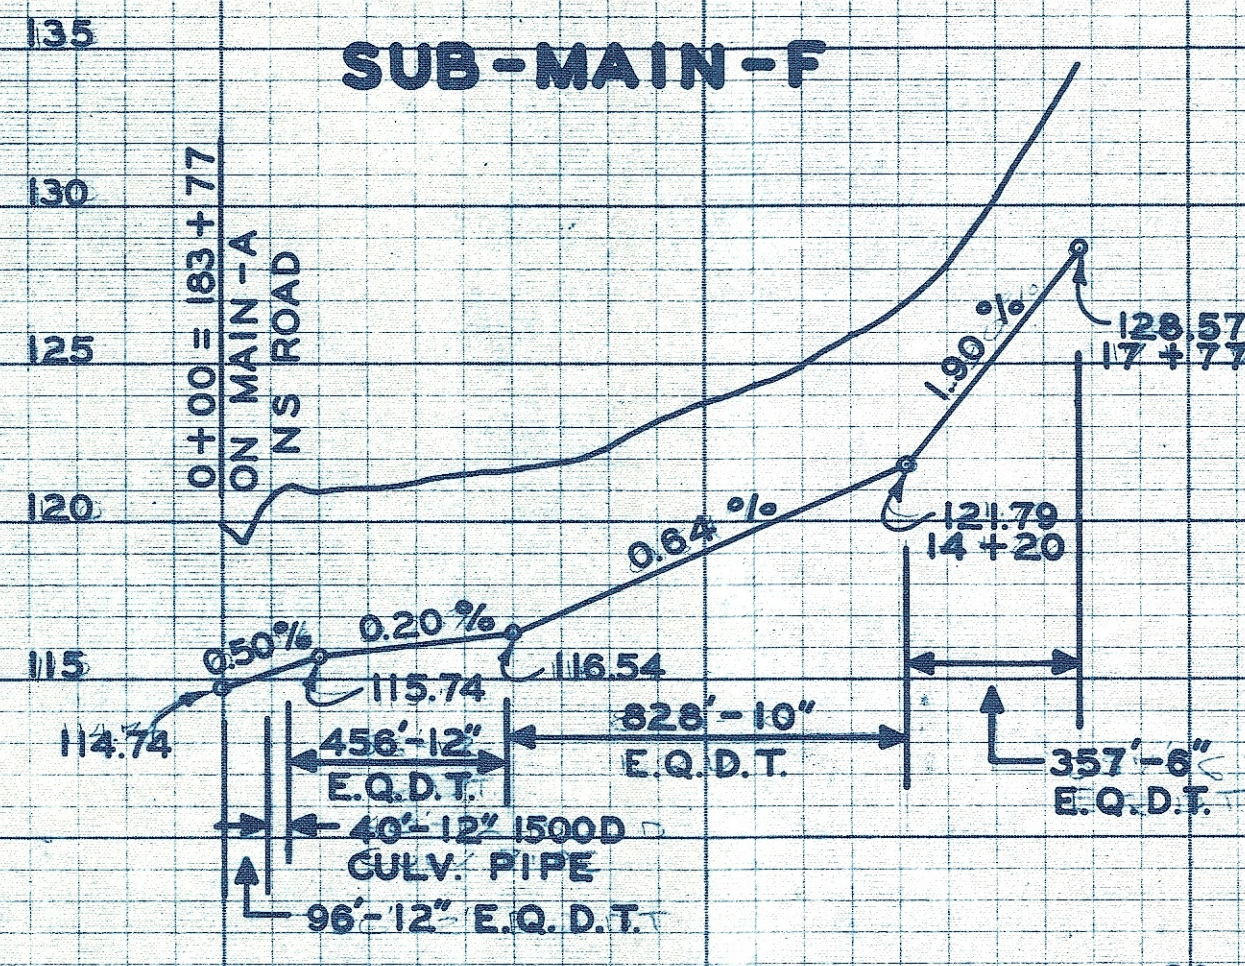


SUB-MAIN-D

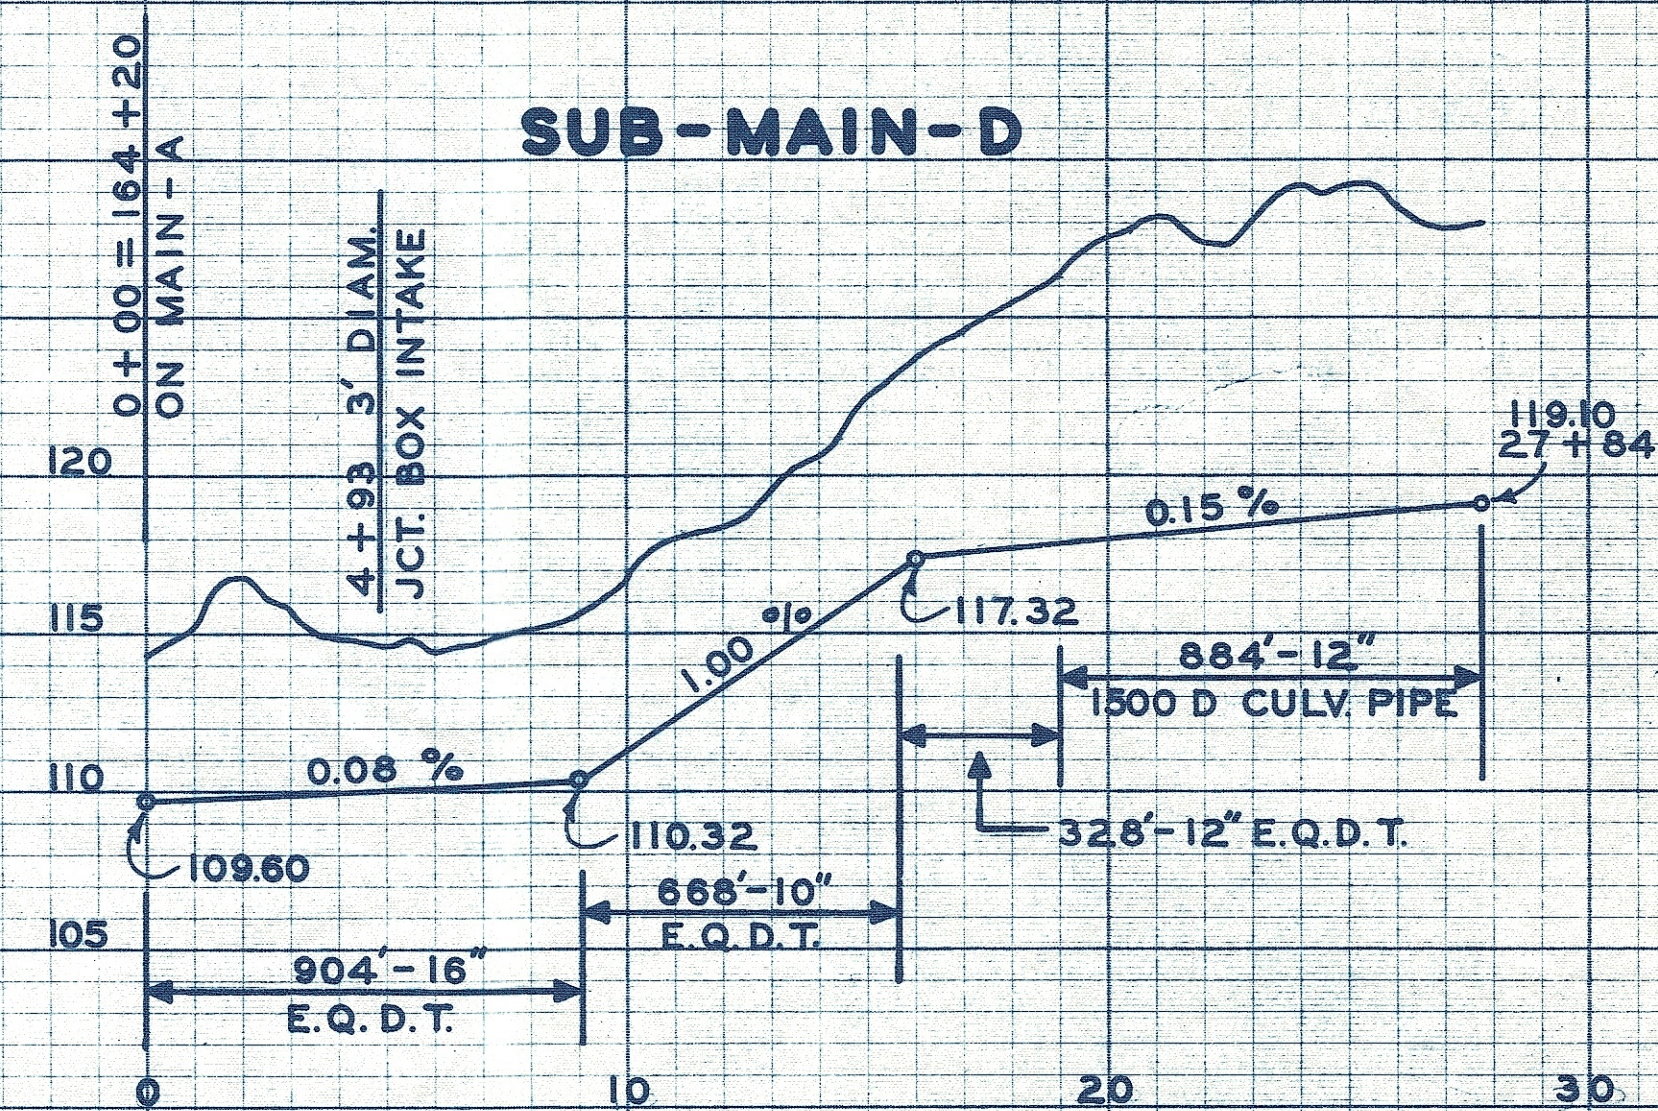


SUB-MAIN-C

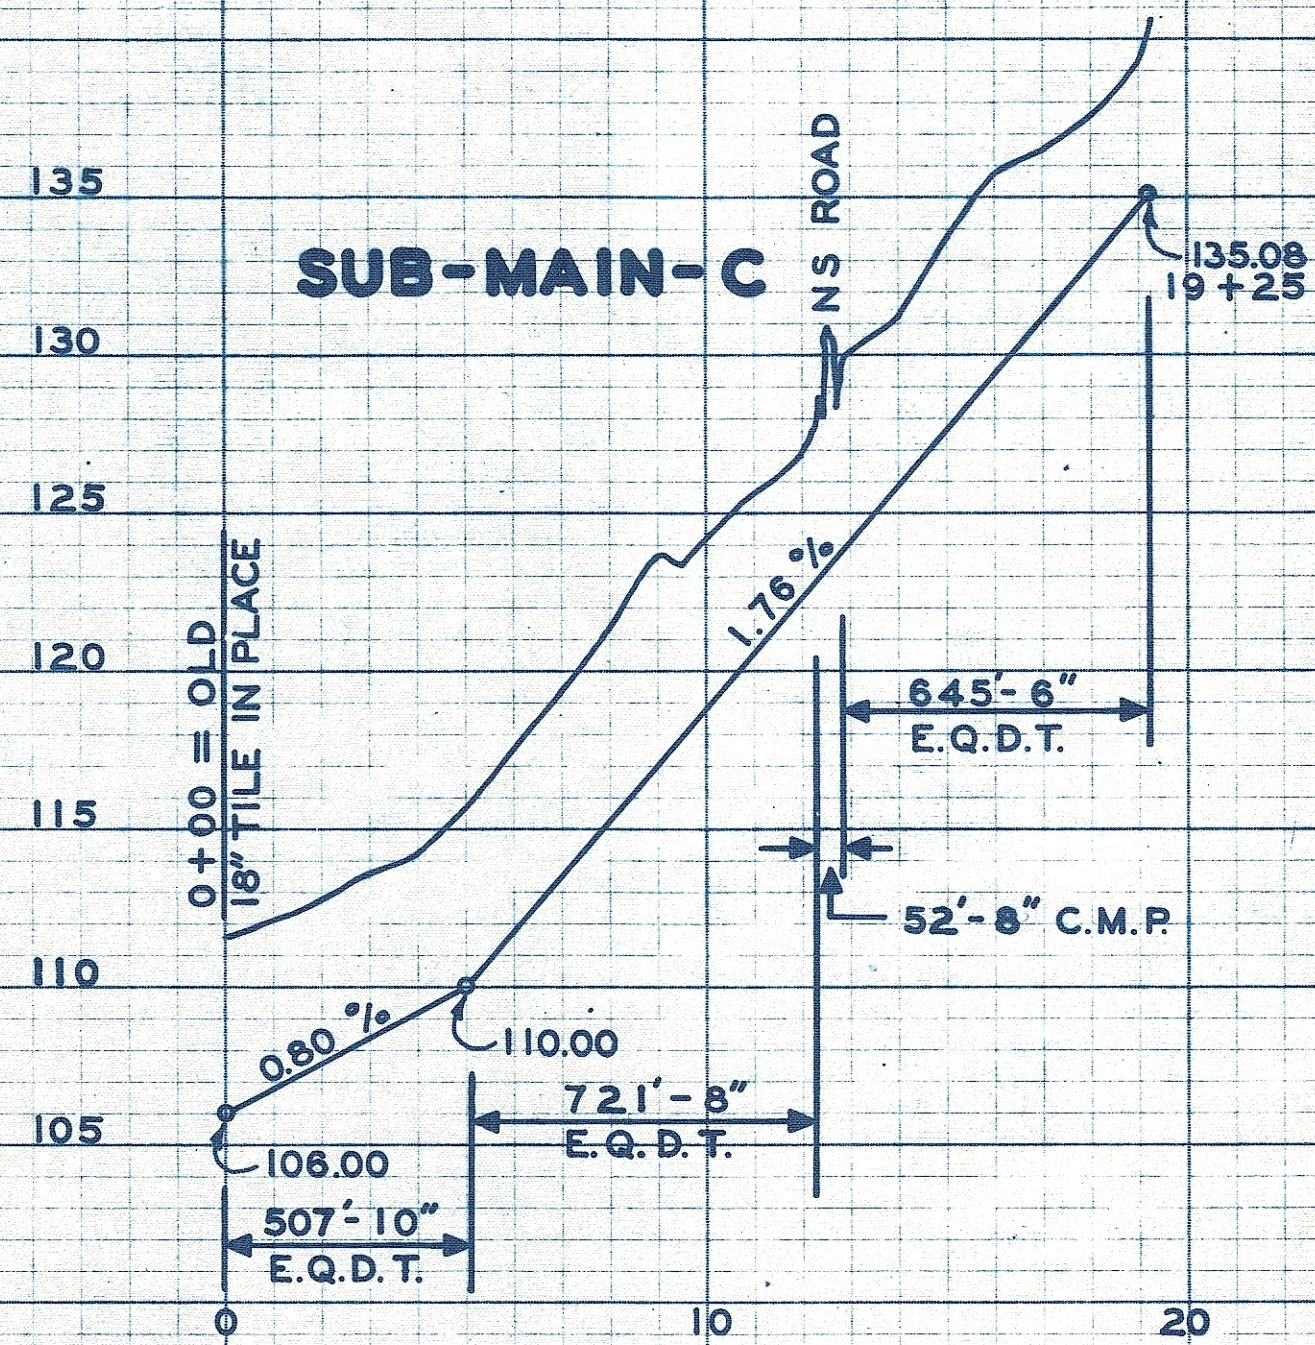

SUB-MAIN-B

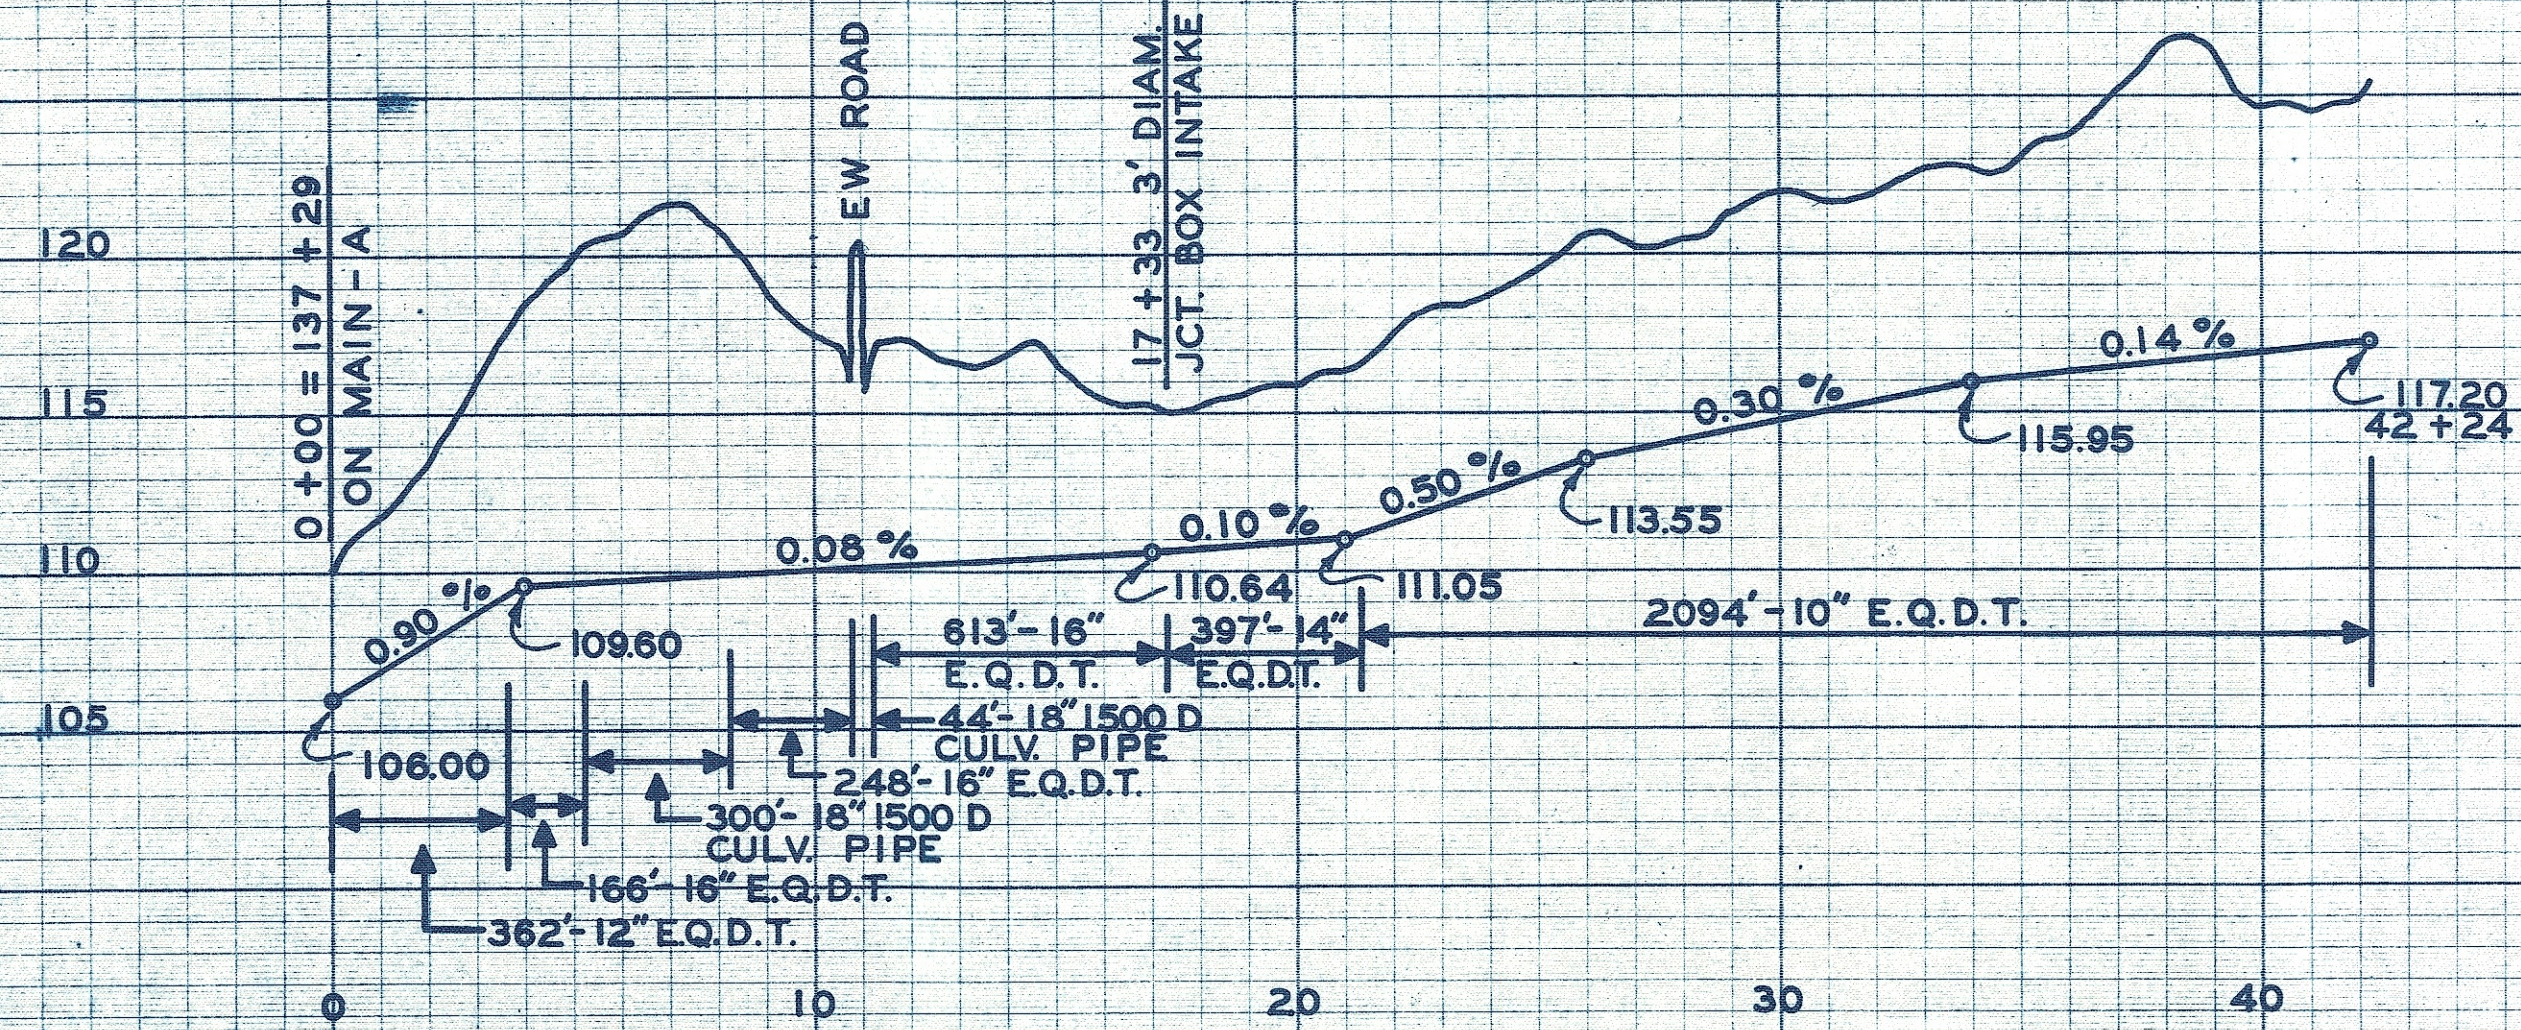

MAIN-A

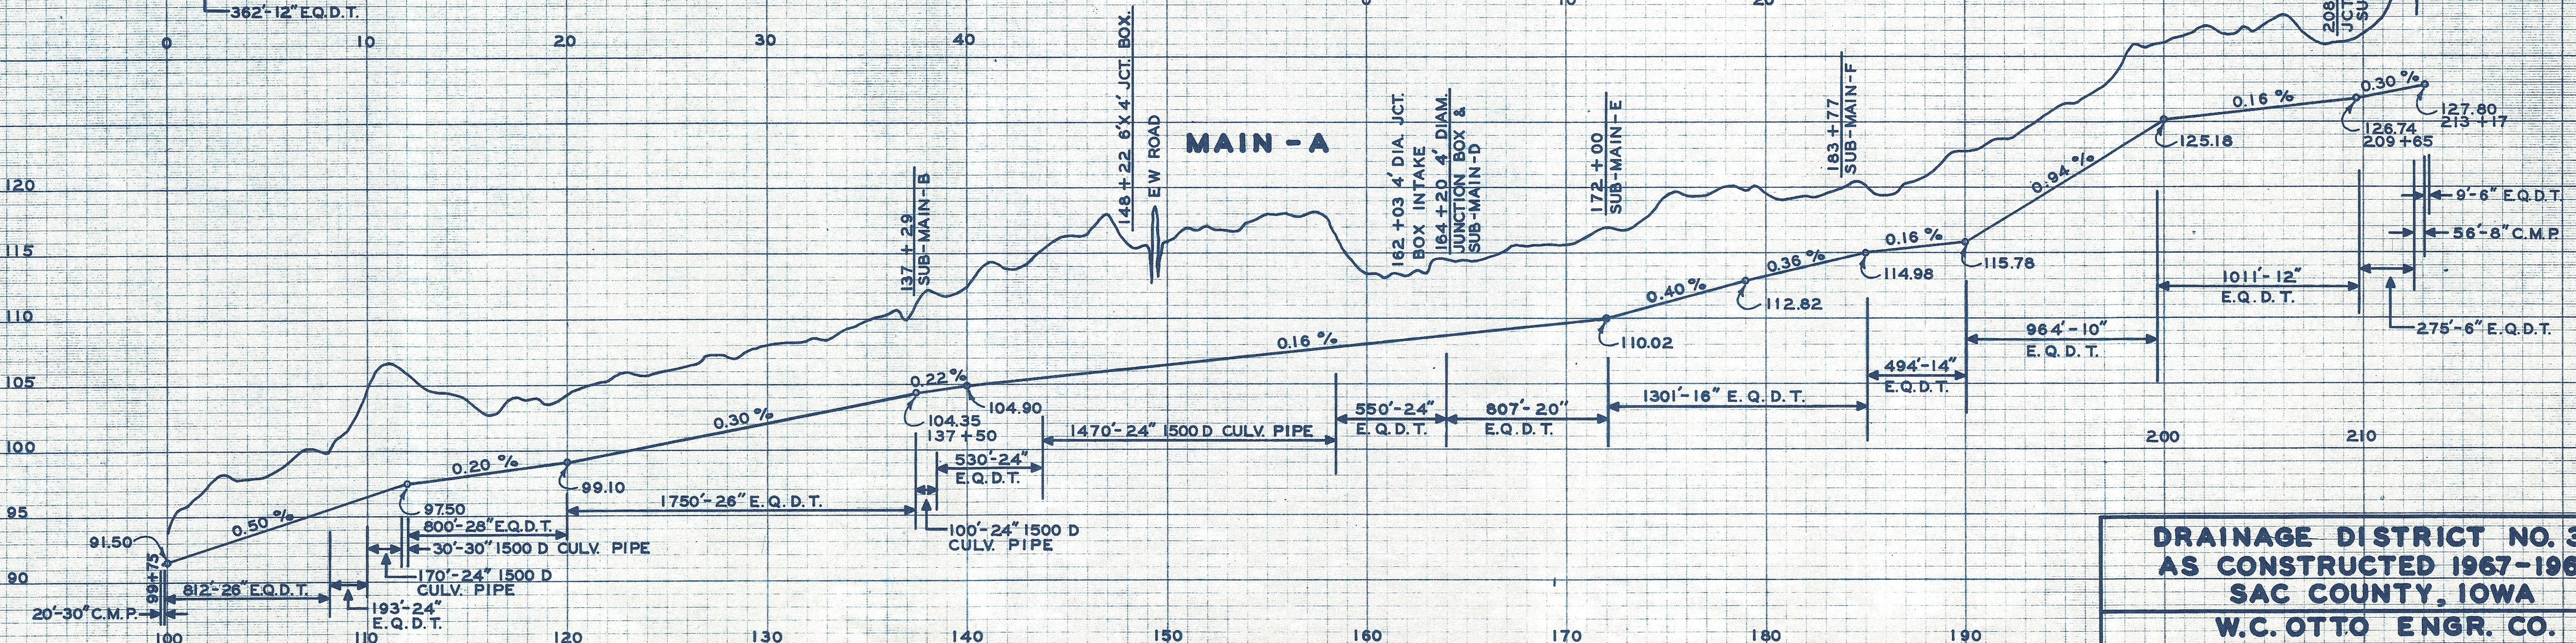

DRAINAGE DISTRICT NO. 35
AS CONSTRUCTED 1967-1968
SAC COUNTY, IOWA
W.C. OTTO ENGR. CO.
SAC CITY, IOWA

Best Profile
 DATE 12/26/1968
 SCALE - AS SHOWN
 SHEET NO. 2 OF 2